


These drawings are to be an instrument of service and shall remain the property of the Architect. They are not to be used on other projects or extensions to this project except by agreement in writing and with appropriate compensation to the Architect. Contractor is responsible for confirming and correlating dimensions at the job site; the Architect will not be responsible for construction means, methods, techniques, sequences or procedures, or for safety precautions and programs in connection with the project.

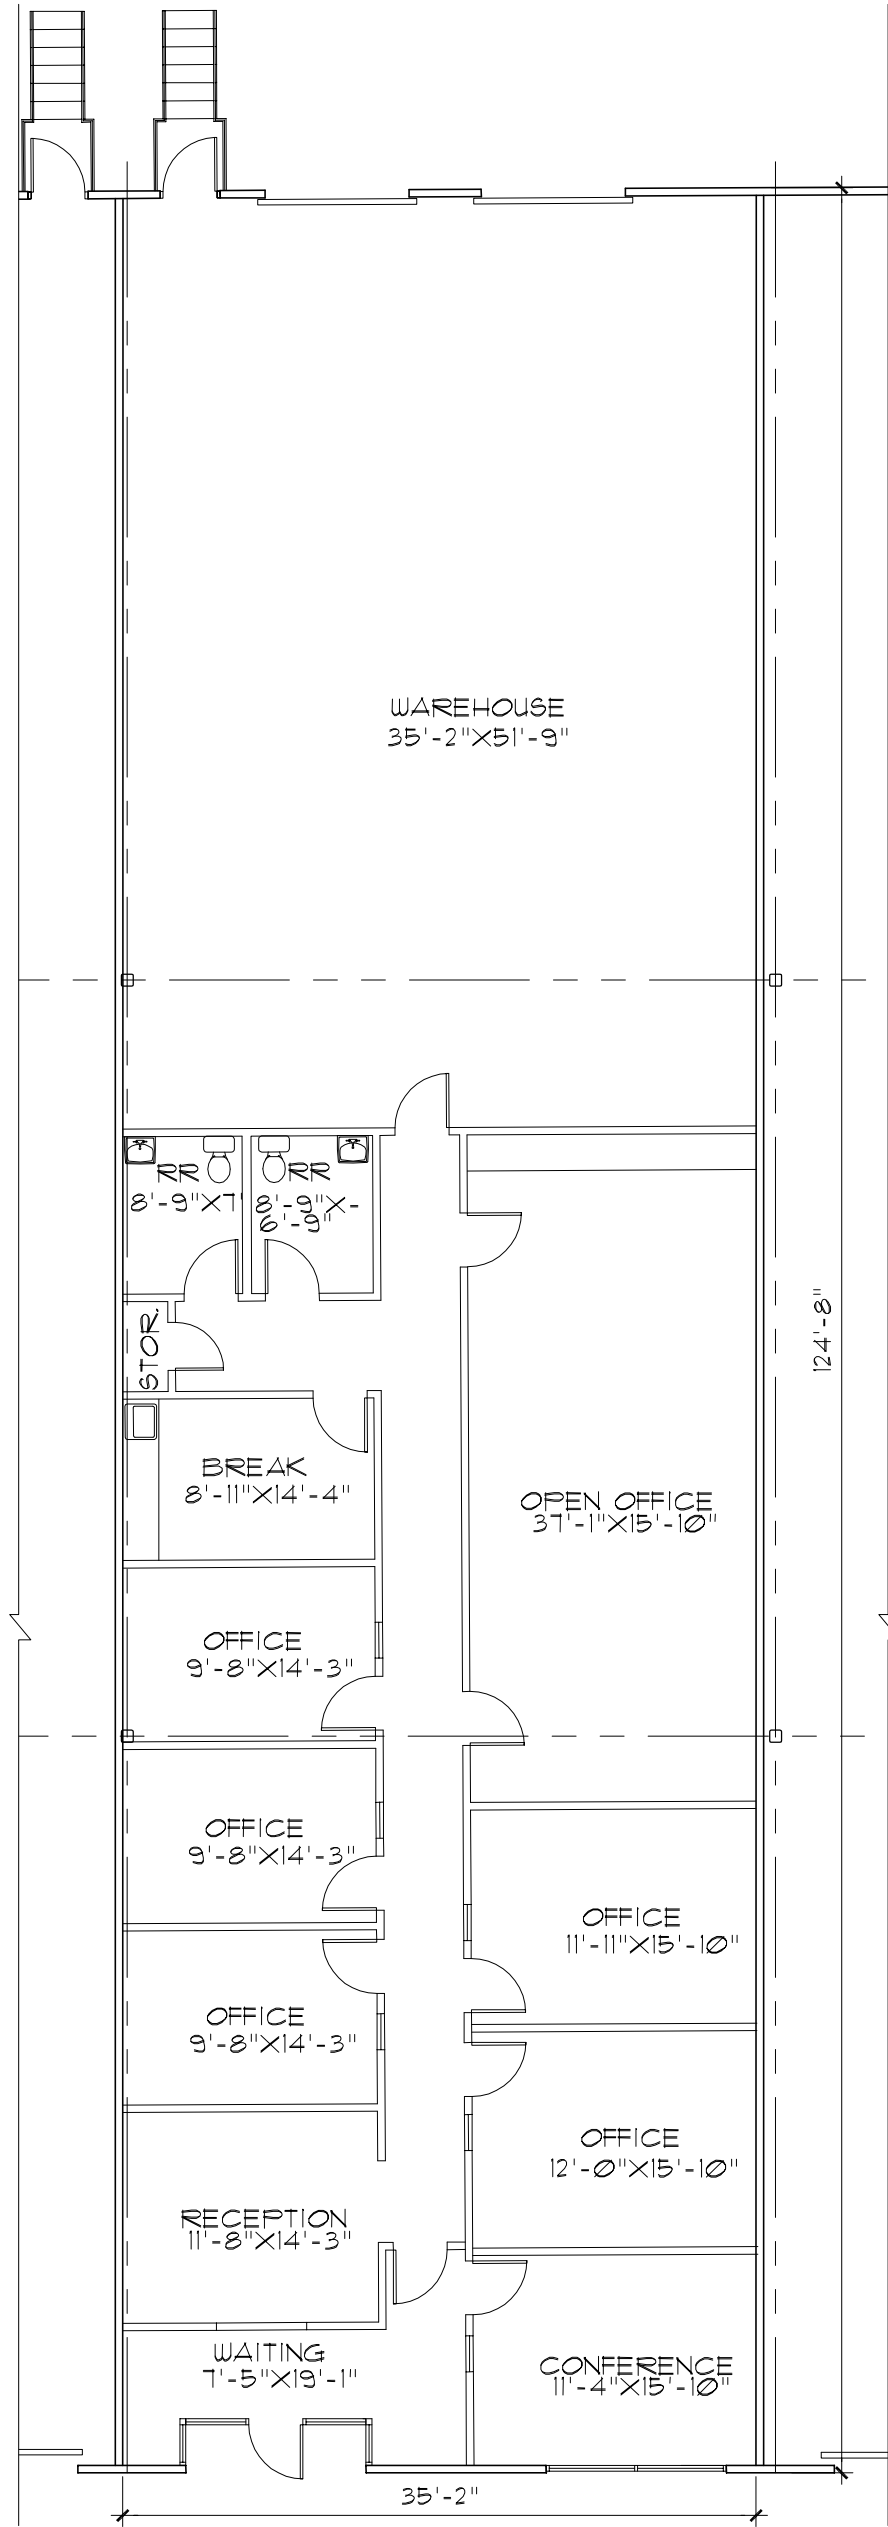

AS-BUILT FLOOR PLAN - 4,500 SF.
SCALE: 3/32"=1'-0"

LEASE AREA:	
OFFICE:	2,651 S.F.
WAREHOUSE:	1,849 S.F.
TOTAL:	4,500 S.F.

AB1

DRAWN	AEV
CHECKED	MDN
DATE	01/16/17
PROJECT	AS-BUILTS
JOB. NO.	13-275
SHEET	

FLOOR PLAN

10564 SENTINEL
SAN ANTONIO, TEXAS



VILLA PARK

ARCHITECTURE/PLANNING/INTERIORS
300 W. BITTERS, SUITE 204 VOICE: (210) 384-8900
SAN ANTONIO, TX. 78216 FAX: (210) 384-8240

© 2017 ALL RIGHTS RESERVED