


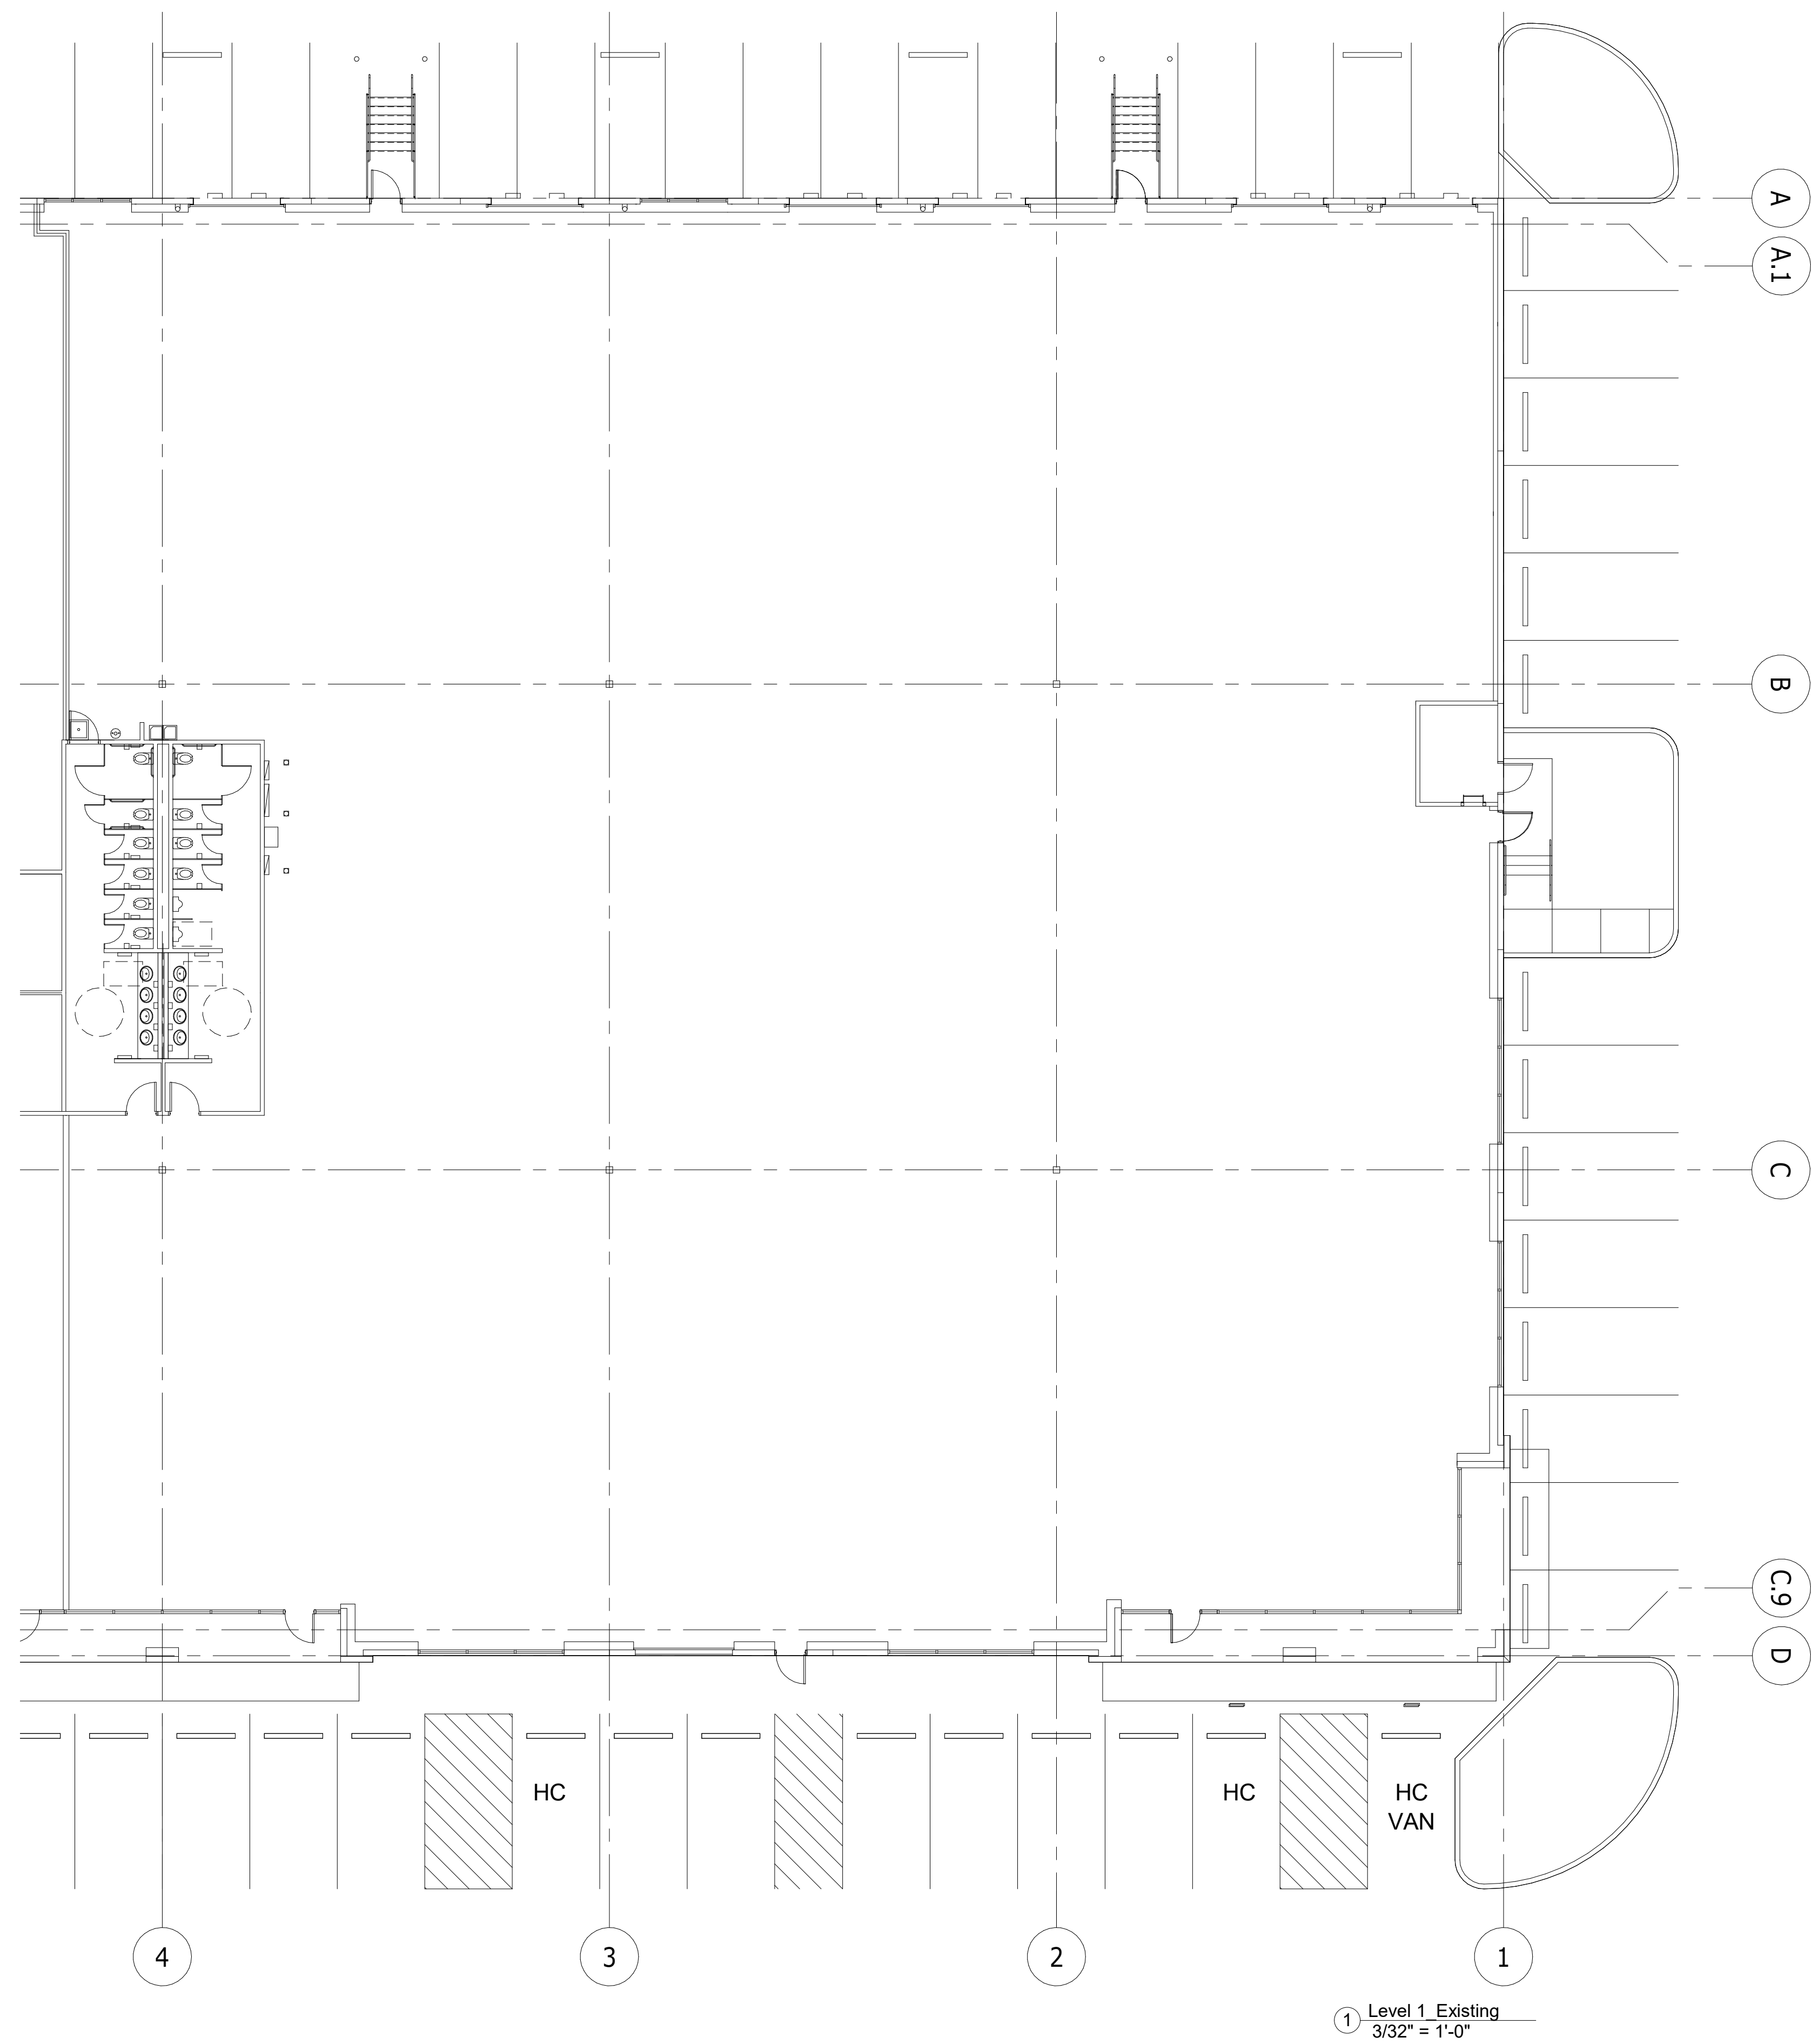

Wetmore Bldg. 3- Suite 301 - As-Built Floor Plan

12625 Wetmore Rd. Suite 301, San Antonio, TX 78247

Scale: 3/32" = 1'-0"

Area: 22,262 SF

09/06/23

LKDG Prj. No: 21358