


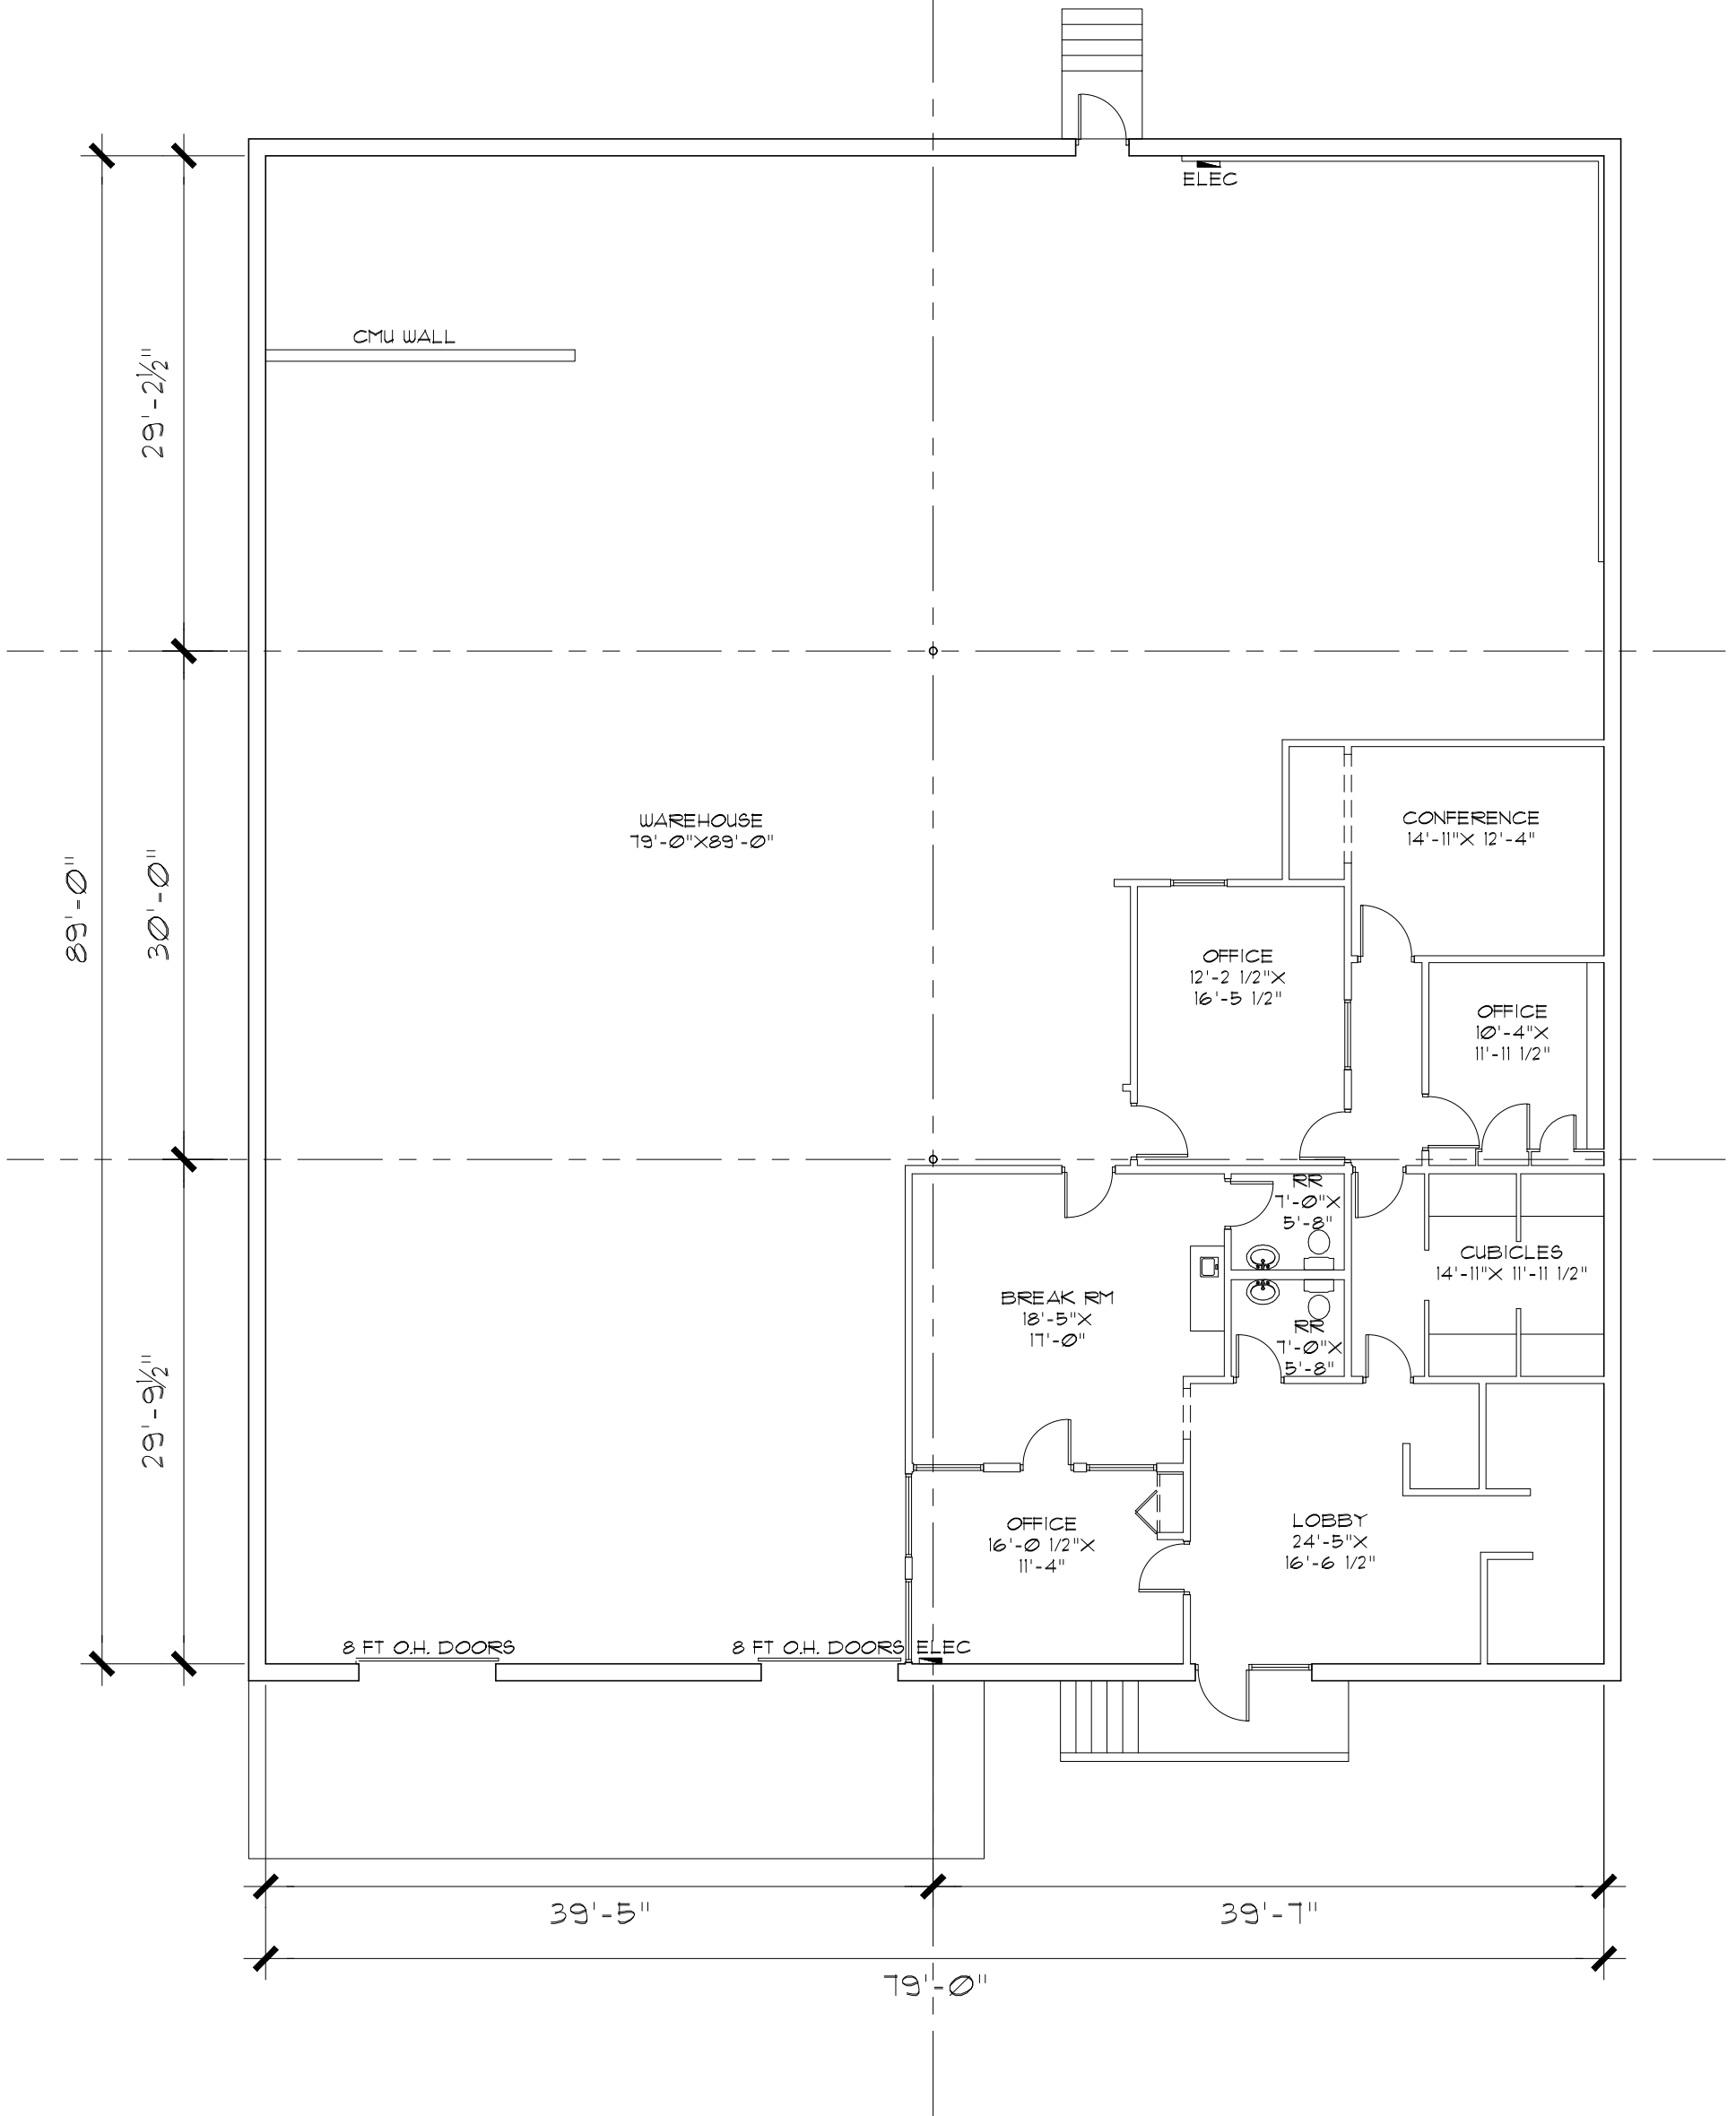

AS-BUILT FLOOR PLAN 7,200 SF

SCALE: GRAPHIC 0' 5' 10' 15'



AB1-012919

AS BUILT FLOOR PLAN

1750 SHIPMAN DR
SAN ANTONIO, TEXAS



AB1

DRAWN	LAP
CHECKED	MDN
DATE	01/29/19
PROJECT	1750 SHIPMAN DR
JOB NO.	19-030
SHEET	