


150'-0"

150'-0"

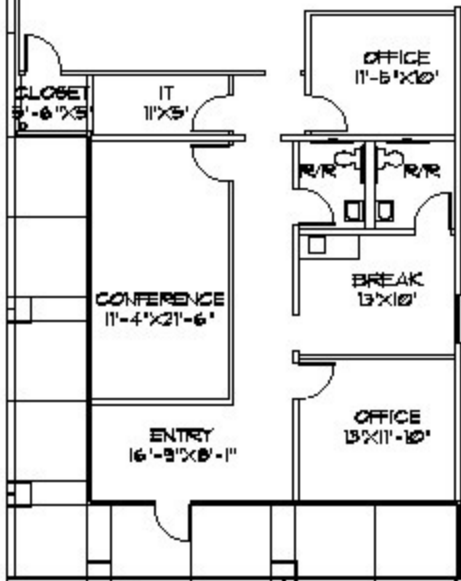

CLOSET  
5'-6" x 5'

IT  
11' x 5'

OFFICE  
11'-5" x 10'

CONFERENCE  
11'-4" x 21'-6"

BREAK  
13' x 10'

ENTRY  
16'-9" x 8'-1"

OFFICE  
13' x 11'-10"

# AS-BUILT PLAN

SCALE: 1/16"=1'-0"



NORTH