


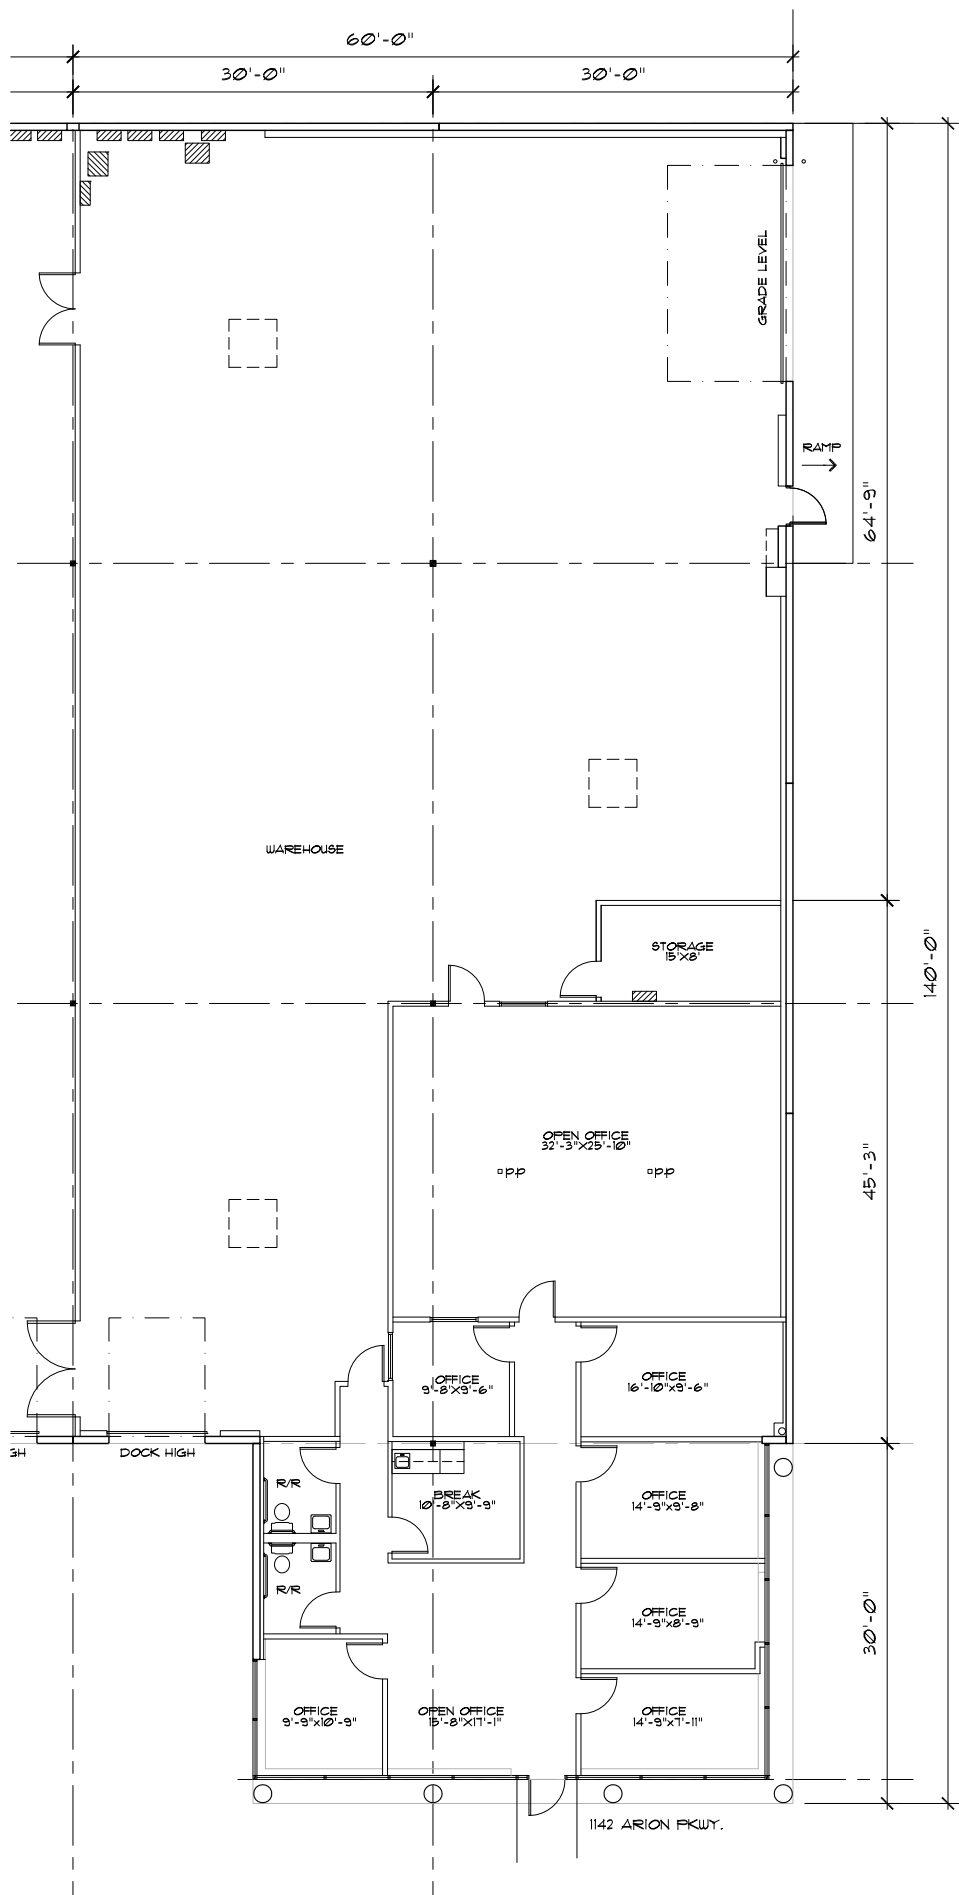

AS-BUILT FLOOR PLAN-7,950 S.F.

SCALE: 1/16" = 1'-0"



LEASE AREA: 1142 ARION	
OFFICE:	2,741 SF.
WAREHOUSE:	5,209 SF.
TOTAL:	7,950 SF.

NOTE: ALL DIMENSIONS ARE APPROXIMATE AND ALL INFORMATION IS OF GENERAL NATURE

AB1-041618

AB1

DRAWN	AEV
CHECKED	MDN
DATE	04/16/18
PROJECT	1140-1142 ARION PKWY
JOB. NO.	18-101
SHEET	

AS-BUILT FLOOR PLAN

1142 ARION PKWY
SAN ANTONIO, TEXAS



ARCHITECTURE/PLANNING/INTERIORS, PLLC
300 W. BITTERS RD., SUITE 204 VOICE: (210) 384-8900
SAN ANTONIO, TX. 78216 FAX: (210) 384-8240

© 2018 ALL RIGHTS RESERVED